



807 GERVAIS STREET
SUITE 302
COLUMBIA, SC 29201

WWW.THEMETHODWORKS.COM

Aiken Intermediate – Bus Transportation Office Aiken County Public School District

October 6, 2026

Addendum No. 02

The following document shall take precedence over the drawings and specifications for the Aiken Intermediate – Bus Transportation Office project and shall become part of the Contract Documents. Any item noted in the Specifications and/or the Construction Documents that is not specifically noted to be modified in this document shall remain unchanged.

Attachments

Drawings:

1. A4.1

Specifications:

None.

Other Attachments:

1. Current Document Distribution List

General

Bid Opening:

The Bid Opening will be held at the Aiken County Public Schools Operations Center, Facilities Construction Department, at 61 Given Street, Aiken, SC 29805 at **2:00pm on October 12, 2026**, as listed in the Invitation to Bid.

Please note that October 12, 2026, is a federal holiday and this may affect mail deliveries. It is the responsibility of the Bidder to ensure that their bid is received by the Owner prior to 2:00pm on October 12, 2026.

Drawings

The following changes to the Drawings are to be incorporated into the Contract Documents. Reissued sheets shall be used for Construction and replace previously issued documents. Please review all reissued sheets in their entirety.



807 GERVAIS STREET
SUITE 302
COLUMBIA, SC 29201

WWW.THEMETHODWORKS.COM

1. Drawing A4.1

- a. See revisions regarding exterior vinyl siding finishes.

Specifications

The following changes to the Specifications are to be incorporated into the Contract Documents. Reissued sections shall be used for Construction and replace previously issued specification sections. Please review all reissued sections in their entirety.

None.

Substitution Requests

The following substitution requests have been made. Please see below for requests and responses. All approved requests shall be added as acceptable manufacturers / products in their applicable specification sections. All approved manufacturers / products are required to meet all requirements and items noted in their applicable specification section. Approval of a manufacturer / product does not permit any deviation for any or all specifications requirements and information listed.

None.


Questions

The following questions have been submitted:


1. The Ply Gem vertical siding specified doesn't appear to be available in the color specified. The color options affect the price per carton. Is there another color that may be acceptable?

Response:


Yes, please provide this material in the color, "Sand". See the revised A4.1 sheet attached.

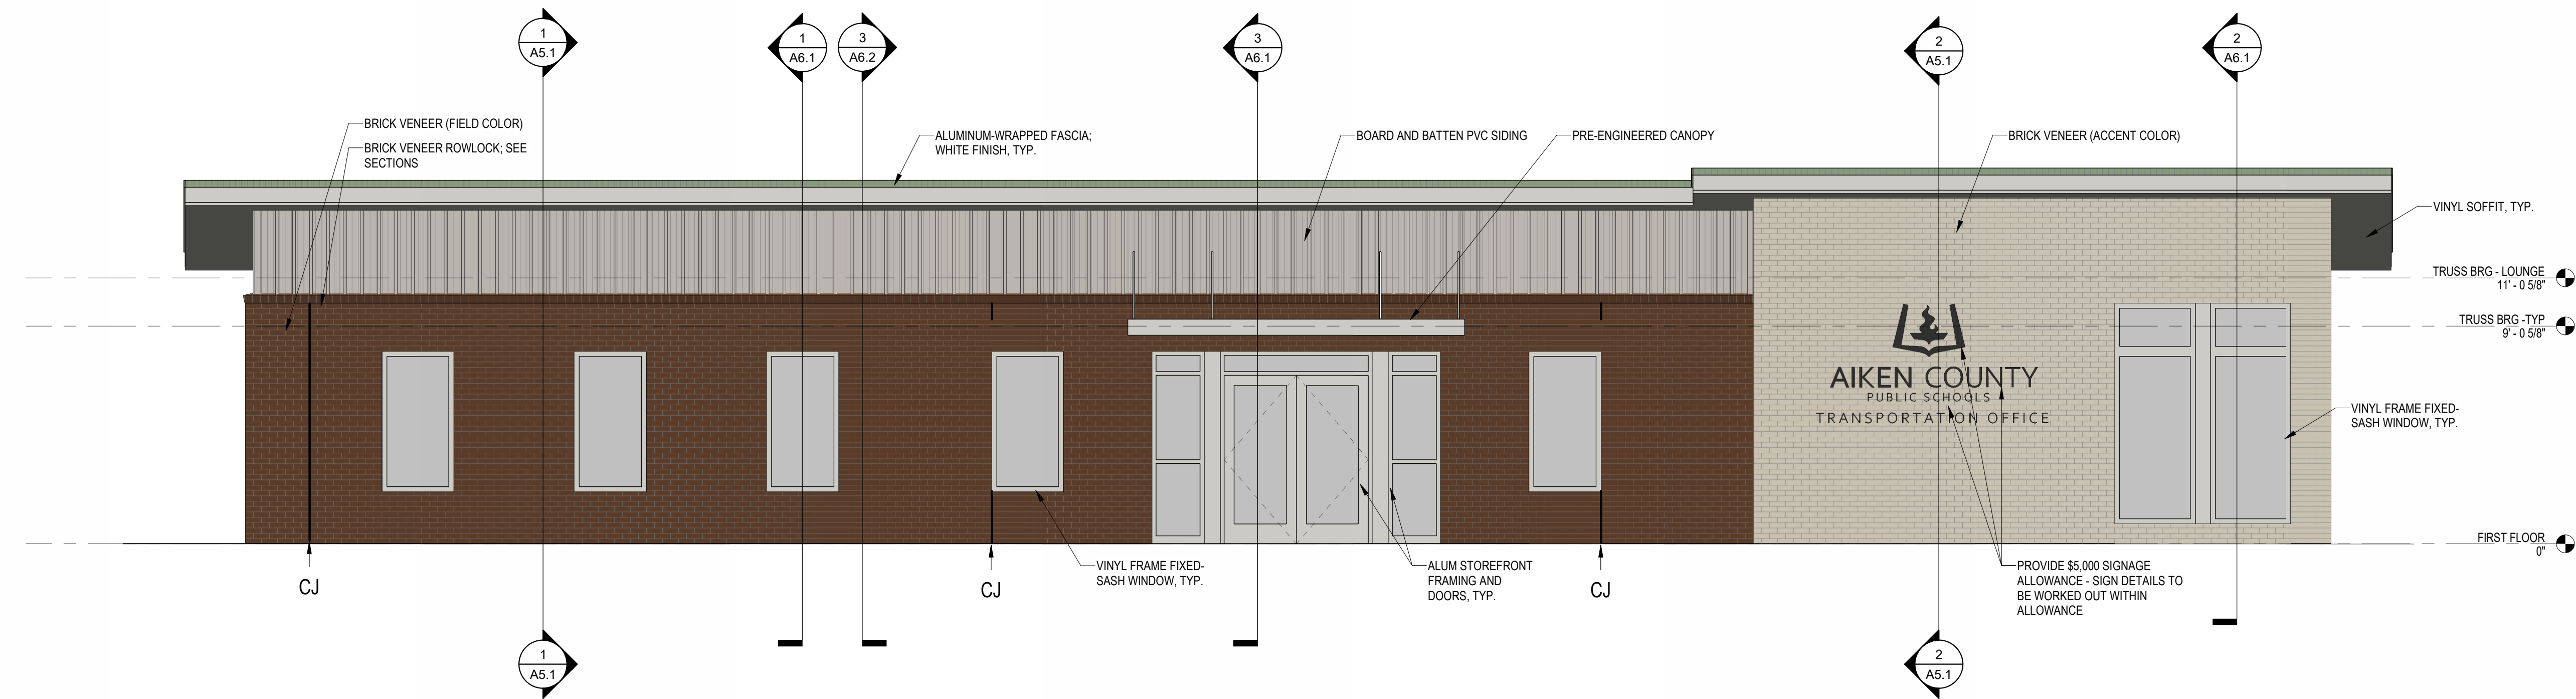


1 PLAN SOUTH ELEVATION
A4.1 1/4" = 1'-0"

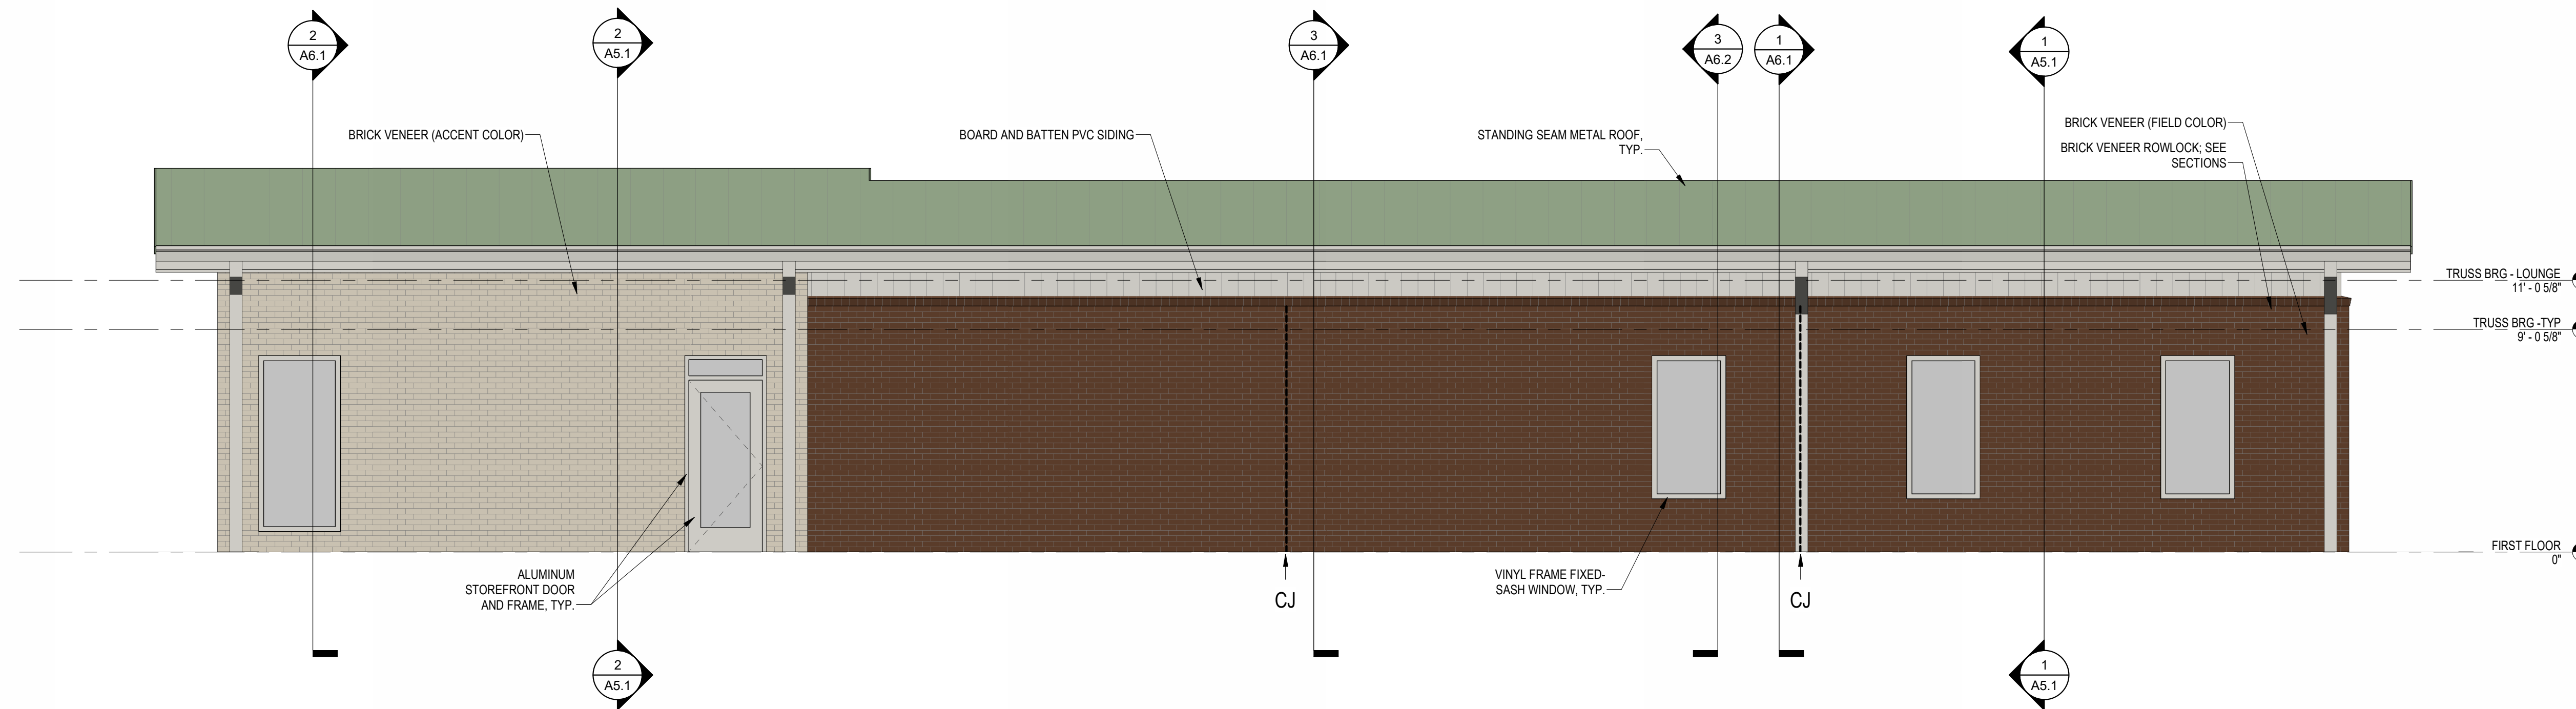

2 PLAN NORTH ELEVATION
A4.1 1/4" = 1'-0"

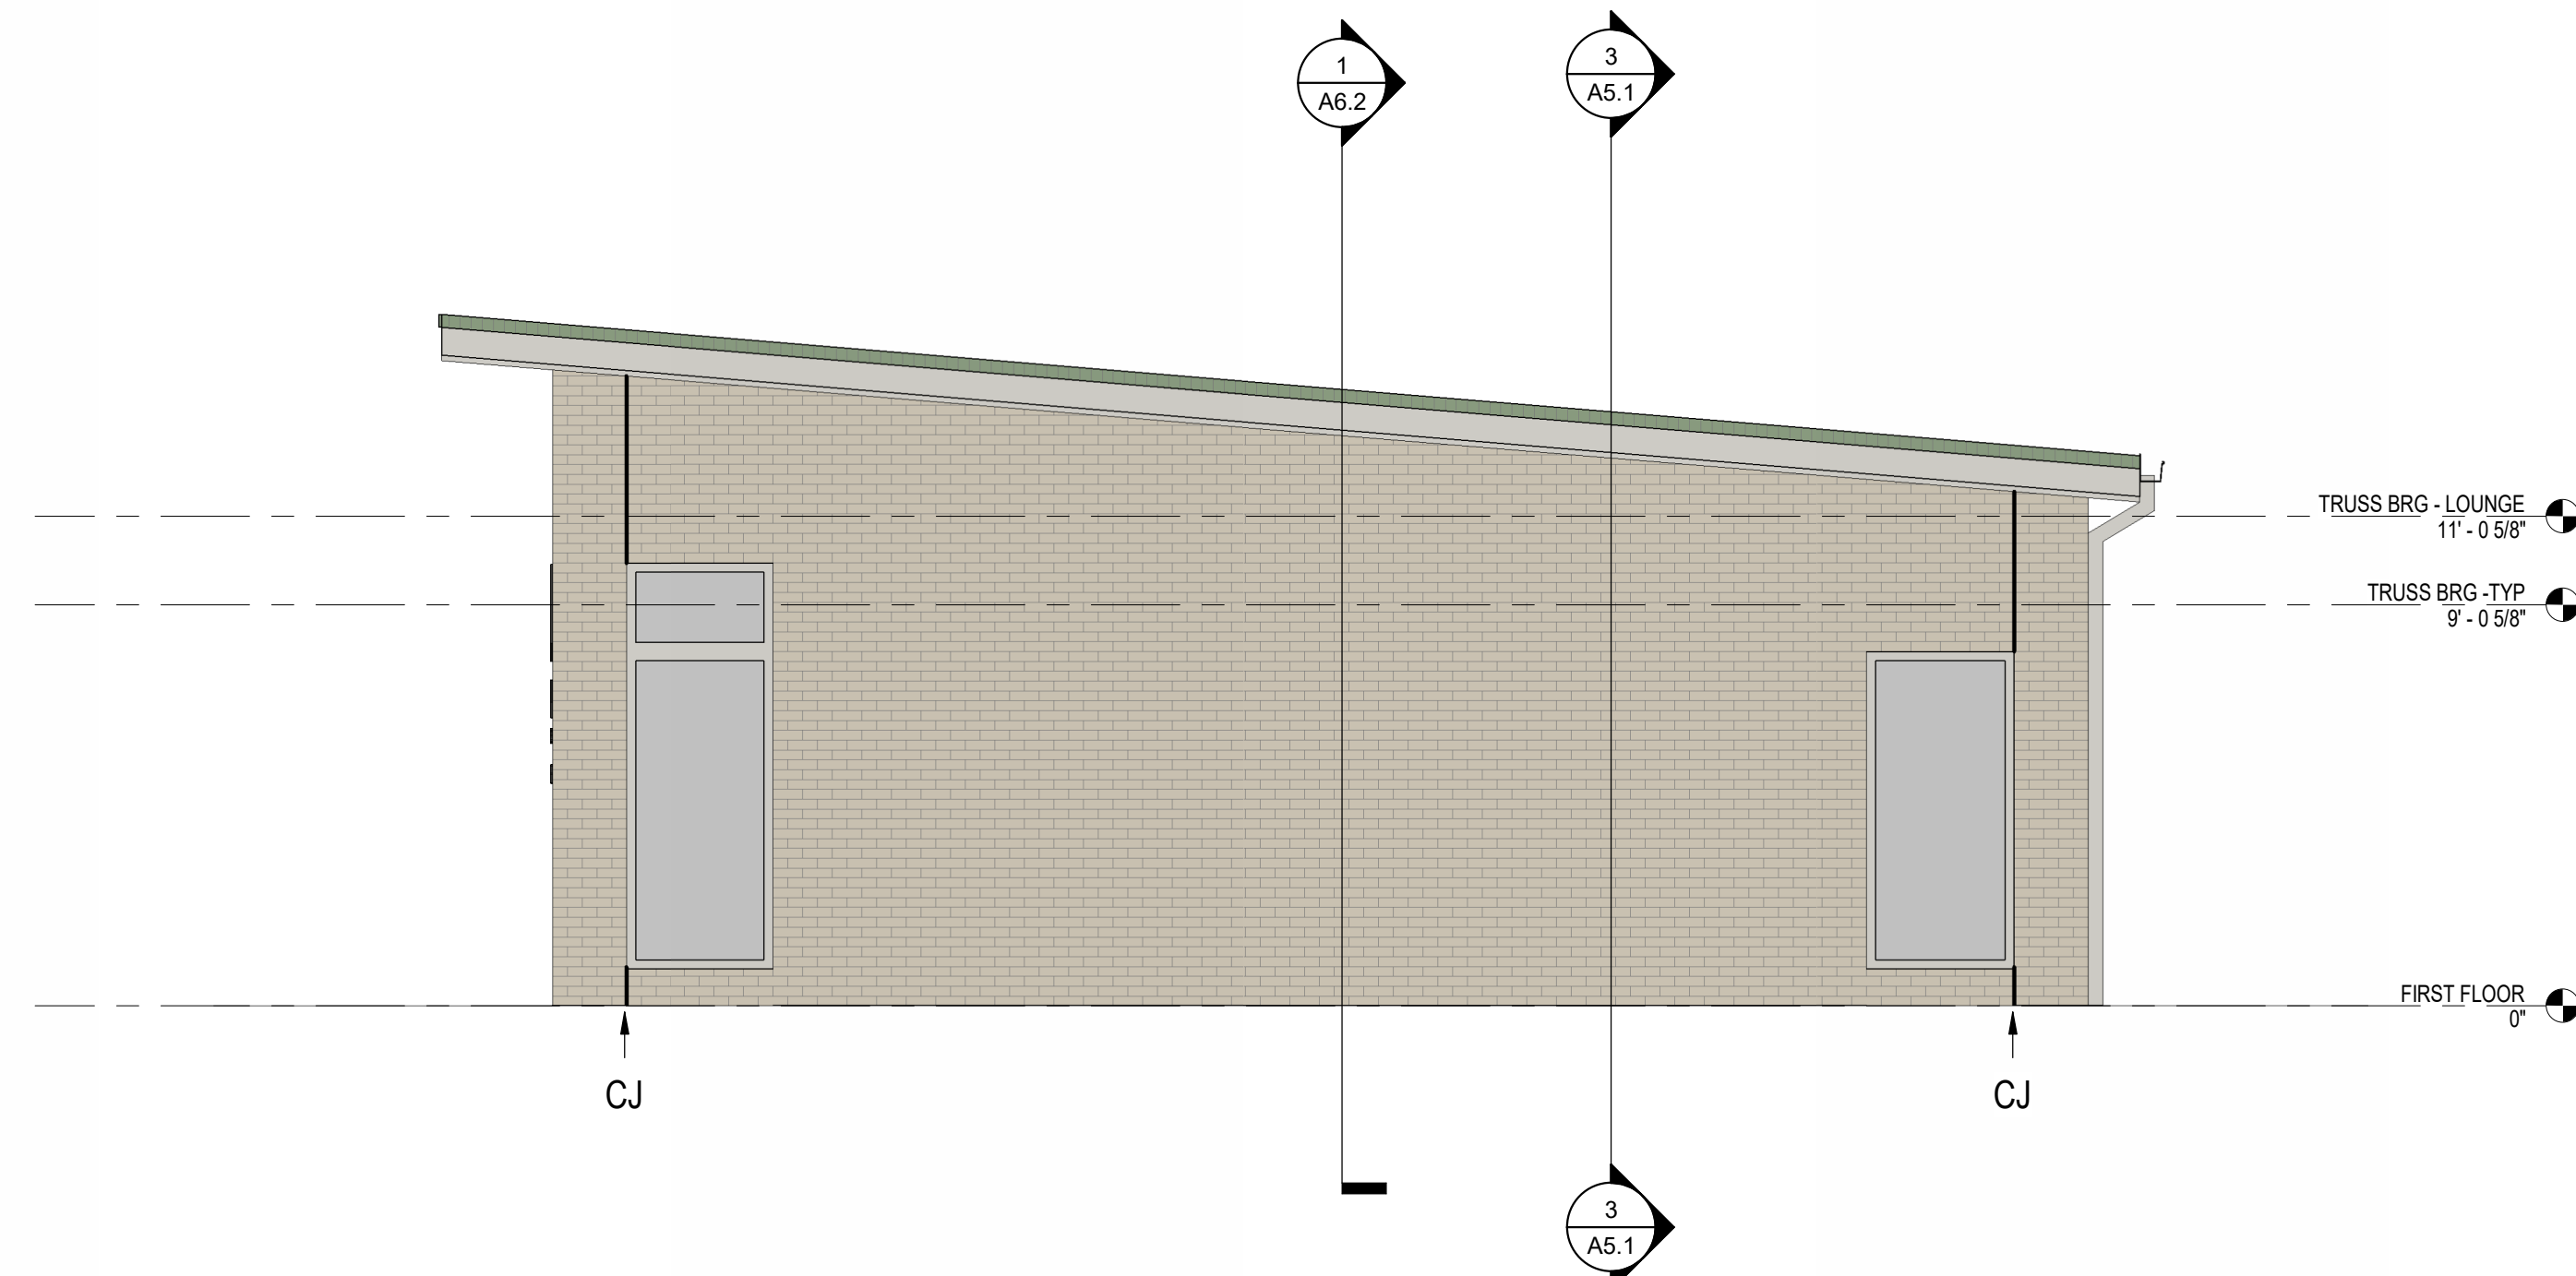

3 PLAN EAST ELEVATION
A4.1 1/4" = 1'-0"

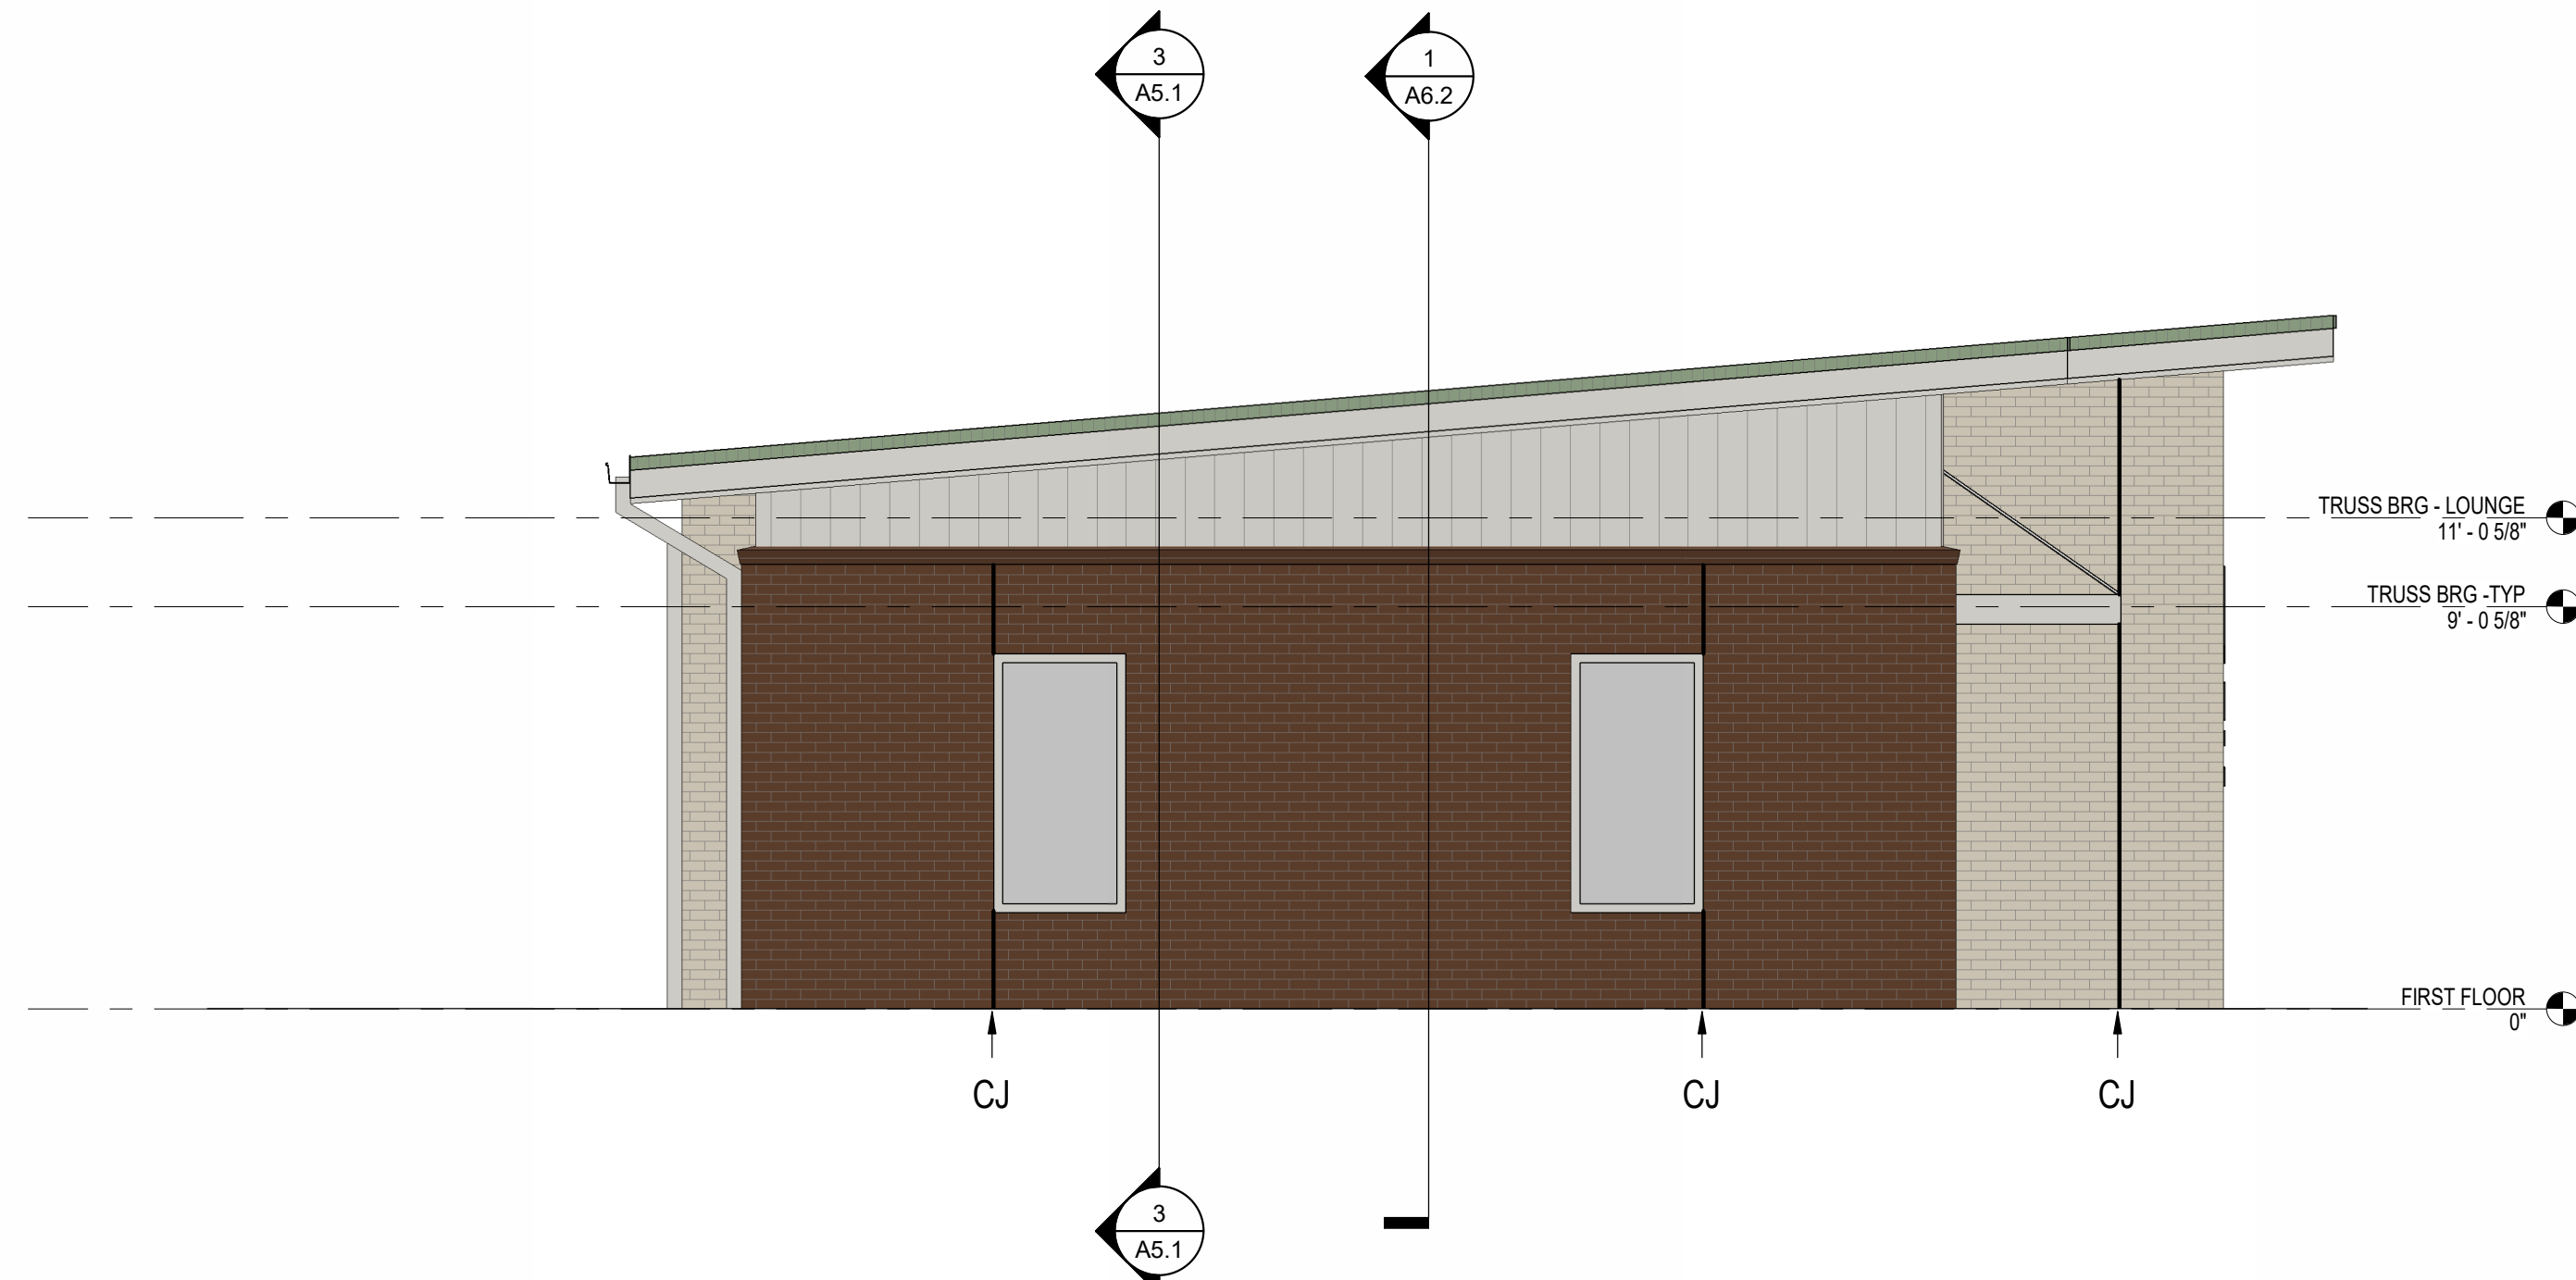

4 PLAN WEST ELEVATION
A4.1 1/4" = 1'-0"

EXTERIOR FINISH LEGEND	
ROOFING:	
• STANDING SEAM METAL:	CONCEALED-FASTENER STANDING SEAM PANEL COLOR: PATINA GREEN (MATCH EXISTING AT SCHOOL ROOF COLOR) BOD: METAL ROOFING SYSTEMS "MRS 1500" 24 GAUGE STEEL 16" PANEL WIDTH WITH STRIATIONS (TO PREVENT OIL CANNING)
PVC/VINYL SIDING:	
• VINYL BOARD AND BATTEN SIDING:	7" PANEL, .048 THICKNESS MINIMUM COLOR: SAND (INCLUDES SIDING, CORNER POSTS, SIDING J CHANNEL) TEXTURE: WOODGRAIN BOD: PLYGEM "MASTIC" BOARD AND BATTEN VERTICAL SIDING
• VINYL SOFFIT PANEL:	PREMIUM DOUBLE-S PANEL, .040 THICKNESS MINIMUM, NON-VENTED COLOR: WHITE (INCLUDES SOFFIT PANEL, J / F CHANNELS FOR SOFFIT) TEXTURE: WOODGRAIN BOD: PLYGEM "MASTIC" UNIVERSAL SOFFIT DOUBLE-S PANEL
BRAKE METAL:	
• BRAKE METAL FASCIA:	.050 MIN. THICKNESS COLOR: WHITE TEXTURE: SMOOTH
• BRAKE METAL TRIM:	.050 MIN. THICKNESS, COLOR: WHITE (MATCH FASCIA) GUTTERS AND DOWNLEADERS: GUTTER COLOR: WHITE (MATCH FASCIA) DOWNLEADER COLOR: WHITE (MATCH FASCIA)
STOREFRONT FRAMING:	
• EXTERIOR STOREFRONT WINDOWS:	4.5" MILLION DEPTH / 2" FACE, WHITE PAINTED FINISH, THERMALLY BROKEN WITH INSULATED GLASS PER GLAZING SCHEDULE COLOR: WHITE BOD: YKK AP YES 45 TU
• EXTERIOR STOREFRONT DOORS:	WIDE STILE, THERMALLY BROKEN WITH INSULATED GLASS PER GLAZING SCHEDULE COLOR: WHITE BOD: YKK AP MONUMENTAL WIDE-STILE ENTRANCE
PRE-ENGINEERED CANOPIES:	
• ALUMINUM CANOPIES:	8" FASCIA WITH INTEGRAL DRAINAGE COLOR: WHITE (MATCH FASCIA / BRAKE METAL)
BRICK VENEER:	
• FIELD BRICK:	SIZE: MODULAR COLOR: RED WIRECUT, WATSONTOWN BRICK (MATCH EXISTING SCHOOL) MORTAR: HOLCIM GRAY, TYPE N
• ACCENT BRICK:	SIZE: MODULAR COLOR: LIGHT GRAY WIRECUT, WATSONTOWN BRICK (MATCH EXISTING SCHOOL) MORTAR: HOLCIM GRAY, TYPE N
SOURCING OF BRICK VENEER:	
BRICK VENEER MUST MATCH EXISTING SCHOOL BUILDING COLORS, AND SHALL BE SOURCED FROM WATSONTOWN BRICK COMPANY, COLUMBIA, SC AND SUPPLIED BY THE EXUM COMPANY, COLUMBIA, SC.	
CONTACT: THE EXUM COMPANY, ATTN: DAN CANNON OR MIKELL SCOTT; PH: 803-254-8951	
EXTERIOR SEALANTS:	
• MASONRY VENEER C/JL JOINTS:	MATCH BRICK COLOR AT JOINT LOCATION
• AROUND WINDOW/DOOR OPENINGS:	MATCH WINDOW/DOOR FRAME COLOR (WHITE)
NOTE - SUBMITTAL OF PHYSICAL MATERIAL SAMPLES:	
ABOVE COLOR SELECTIONS ARE PRELIMINARY. CONTRACTOR MUST PROVIDE ARCHITECT/OWNER WITH PHYSICAL SAMPLES OF ALL EXTERIOR MATERIALS TO INCLUDE SIDING, BRICK VENEER, ROOFING, AND ALL PREFINISHED METAL FOR FINAL COLOR SELECTIONS. NO MATERIALS ARE TO BE ORDERED WITHOUT FINAL SELECTION VIA PHYSICAL MATERIAL SAMPLE.	

METHOD WORKS
ARCHITECTURE

807 Gervais St.
Suite 302
Columbia, SC 29201
www.themethodworks.com

STATE OF SOUTH CAROLINA
METHOD WORKS
ARCHITECTURE, LLC
COLUMBIA, SC
No. 102092
REGISTERED ARCHITECT

STATE OF SOUTH CAROLINA
KEITH S.
RICHEY
COLUMBIA, SC
No. 9556
09/21/2009
REGISTERED ARCHITECT

No.	Revised	Description	Date
1	10/6/26	ISSUED FOR PERMIT	10/6/26
2		ADDENDUM 2	

AIKEN INTERMEDIATE - BUS
TRANSPORTATION OFFICE

AIKEN COUNTY PUBLIC SCHOOL
DISTRICT

101 GATOR LN, AIKEN, SC 29801

Project Number
M-25-119

Drawn By
KSR

Checked By
KSR

Date
09/21/26

Drawing Title
BUILDING ELEVATIONS

Drawing No.
A4.1



807 GERVAIS STREET
SUITE 302
COLUMBIA, SC 29201

WWW.THEMETHODWORKS.COM

Aiken Intermediate – Bus Transportation Office

Project# 101226

Plan Holders List – 10.06.26

Name	Company	Email
1. Cale Collier	Ajax	Cale.Collier@ajaxbuilding.com
2. W. Jordan Gray	J.C. Wilkie Construction	jordang@jcwilkiellc.com
3. Clarke Shelton	Duckworth Development	clarke@duckdllc.com
4. Geno Akers	JNB Contracting Services, LLC	geno.akers@jnbcontracting.com
5. Seth Nicholson	JNB Contracting Services, LLC	seth.nicholson@jnbcontracting.com
6. Rodney Cadorette	Porter Roofing Contractors, Inc.	rodney@porter-roofing.com
7. Diane Coughlin	Clifton Construction	diane@sdclifton.com
8. Leslie Whitehurst	Iverter Mechanical Piping	lwhitehurst@impshvac.com
9. Wendy Warren	JD Gaskins Construction	construct@jdgaskins.com
10. Gregory Williams	Contract Management, Inc.	gregoryw@contractmgmtinc.com
11. Slade Helmly	McKnight Construction	slade@mcknightconstructionco.com
12. Megan Lindsay	Trident Veteran Construction	mlindsay@tridentveteran.com
13. Jonathan Saul	Saul Development Group	jonathan@sauldg.com
14. Justin Walden	BR Walden Construction	brwaldenconstruction@gmail.com
15. Austin Jackson	Kenricks Construction Company	austin@kenricksconstruction.com
16. Bryce Howie	Brown Contractors	bhowie@browntrusted.com
17. Glenn Dillon	Contract Construction	GDillon@contractconstruction.net
18. Patrick Sommers	Sommers Construction	psommers@sommerscc.com
19. Greg Drayton	Farmer Construction	greg@fcllc.biz
20. Mickey Edwards	BLE Corp	mickey.edwards@blecorp.com
21. Brayden Folds	BR Walden Construction	bfoldsbrwaldenconstruction@gmail.com
22. Louis Slattery	Duke McGinnis Consulting	louisslaterry707@gmail.com
23. Emily Mayfield	Owens Construction	emayfield.owensconstruction@gmail.com
24. JNB	JNB	estimating.carolinas@jnbcontracting.com
25. Ross Watson	Cinderella Partners	ross@cinderellapartners.com
26. Josh Dailey	Dailey Development, LLC	j.dailey@daileybuilds.com
27. Tanner Dukes	Spratlin Construction	tanner@spratlinconstruction.com
28. Janica Nichols	GA Hardware Distributors	JNichols@gahardware.com
29. Nathan Stewart	JE Stewart	nathan@stewartbuilders.com
30. Unknown	Concrete Sub	mccga83@yahoo.com
31. Toby Feagin	NetPlanner	toby.feagin@netplanner.com
32. Chaim Fischer	Tudelu	chaim.fischer@tudelu.com
33. Camilla Hester	Duke McGinnis Consulting	hestercamillia@gmail.com
34. Dan Landis	JE Stewart	dan@stewartbuilders.com